

1





2

3

4

5


6

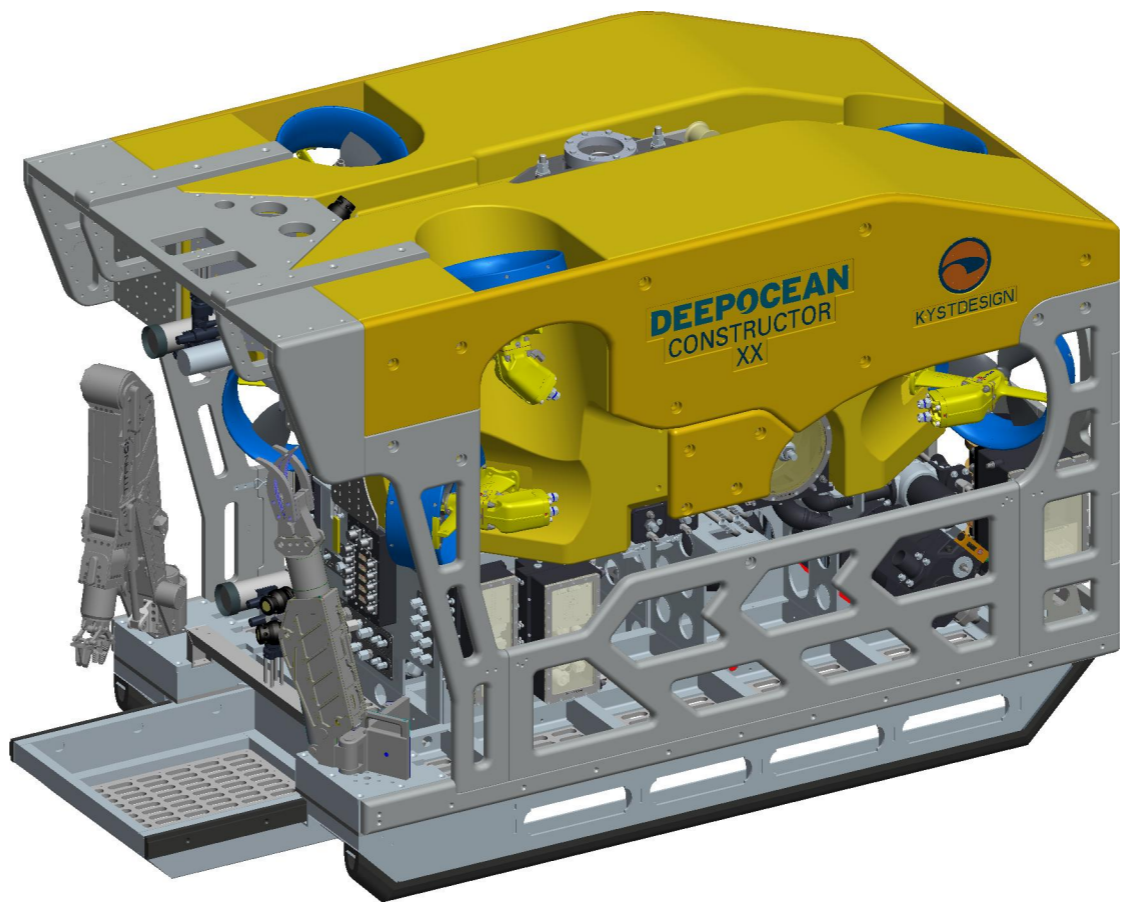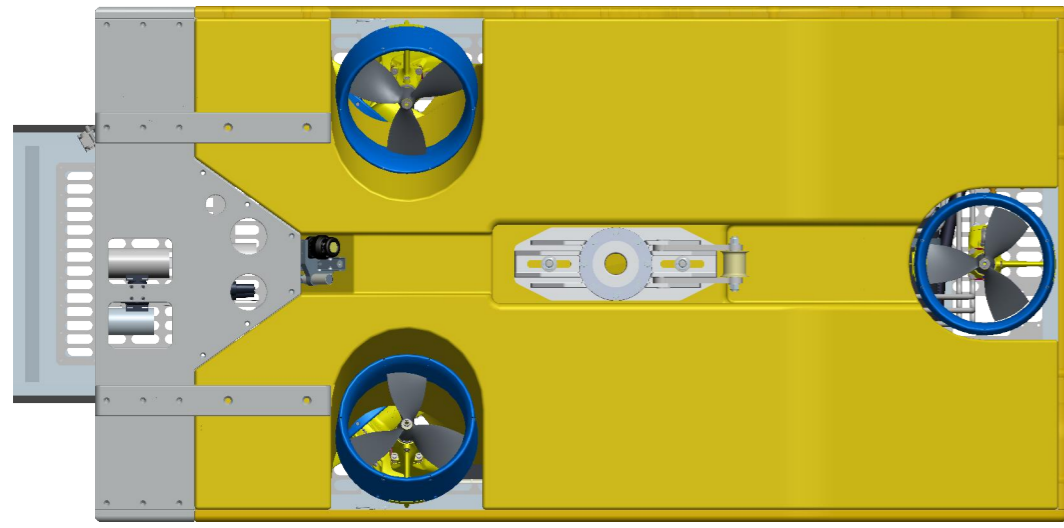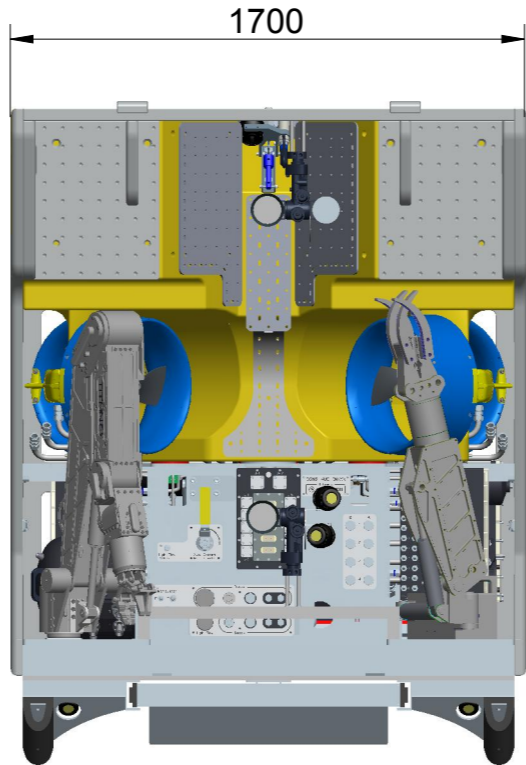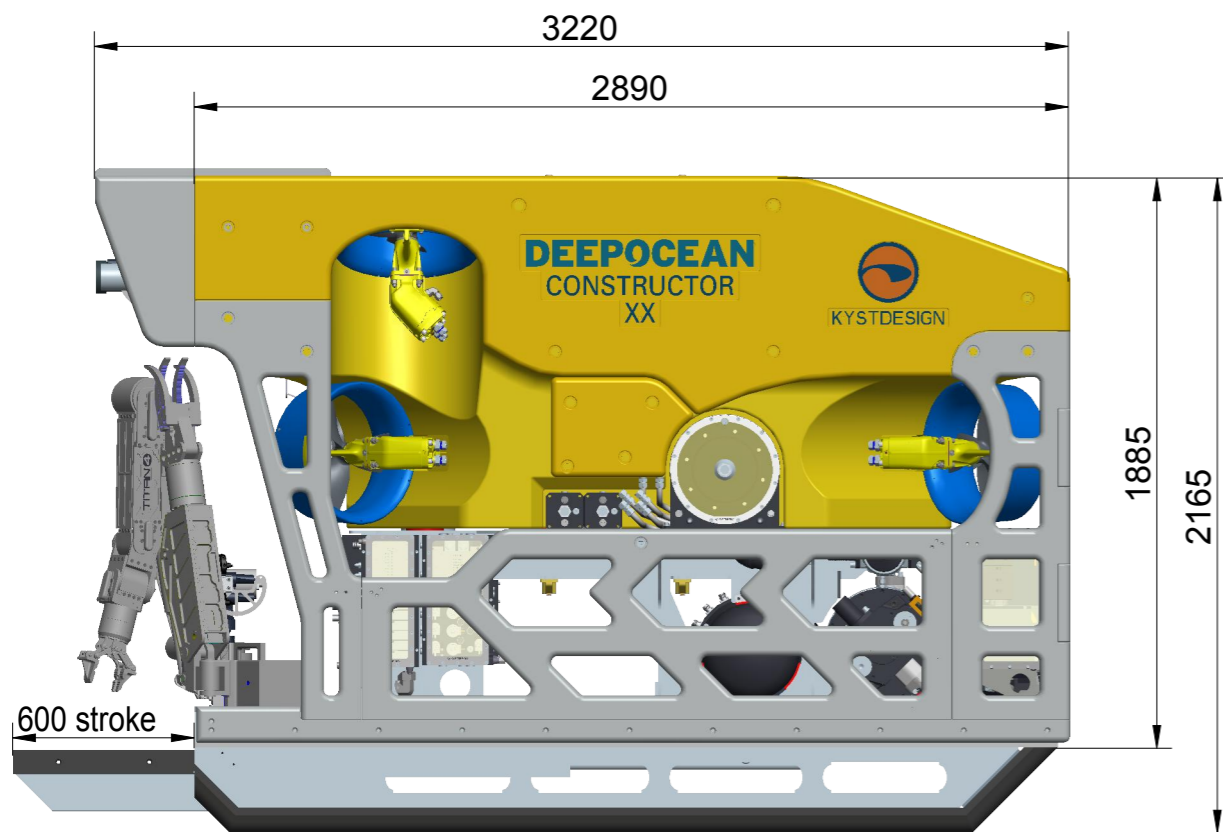

Weight in air:  
 ROV with Skid, Manipulators and Pay load: 4500 kg  
 SWL lift point: 7000 kg  
 Through frame lift: 3000 kg  
 Pay load: ~500 kg  
 Depth Rating: 3000 msw


Itm.	Qty.	Description	Drg. / Spec.	Material	
01	26.04.13	AS BUILT	GVI	AHO EKB	
A	24.03.13	ISSUED FOR COMMENTS	GVI	AHO EKB	
Rev.	Date	Description	Prep	Chk	App

# CONSTRUCTOR

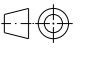Drawing title CONSTRUCTOR With Skid General Arrangement		 Size <b>A3</b>
KYSTDESIGN AS Strandgaten 202, 5525 Haugesund, NORWAY Tel: +47 52 70 62 50 Fax: +47 52 70 62 01 www.kystdesign.no	Scale 1:25 File name AF25-1000M01	
		Sheet 1 of 4

in the information contained therein. Reproduction, use or disclosure to third parties without consent is strictly forbidden.  
 KYSTDESIGN AS