

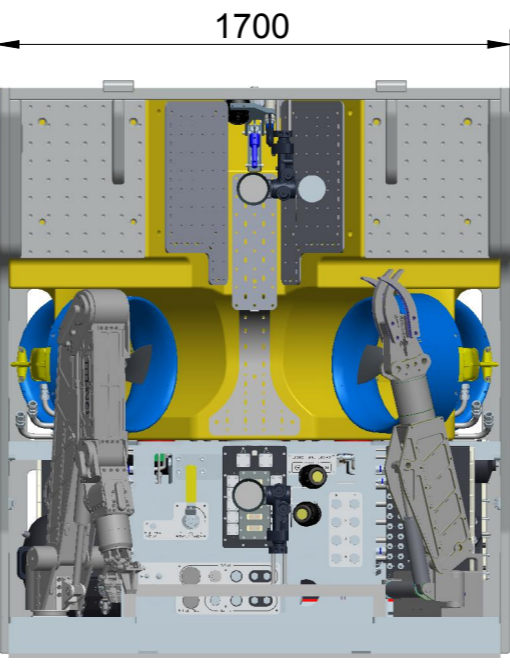
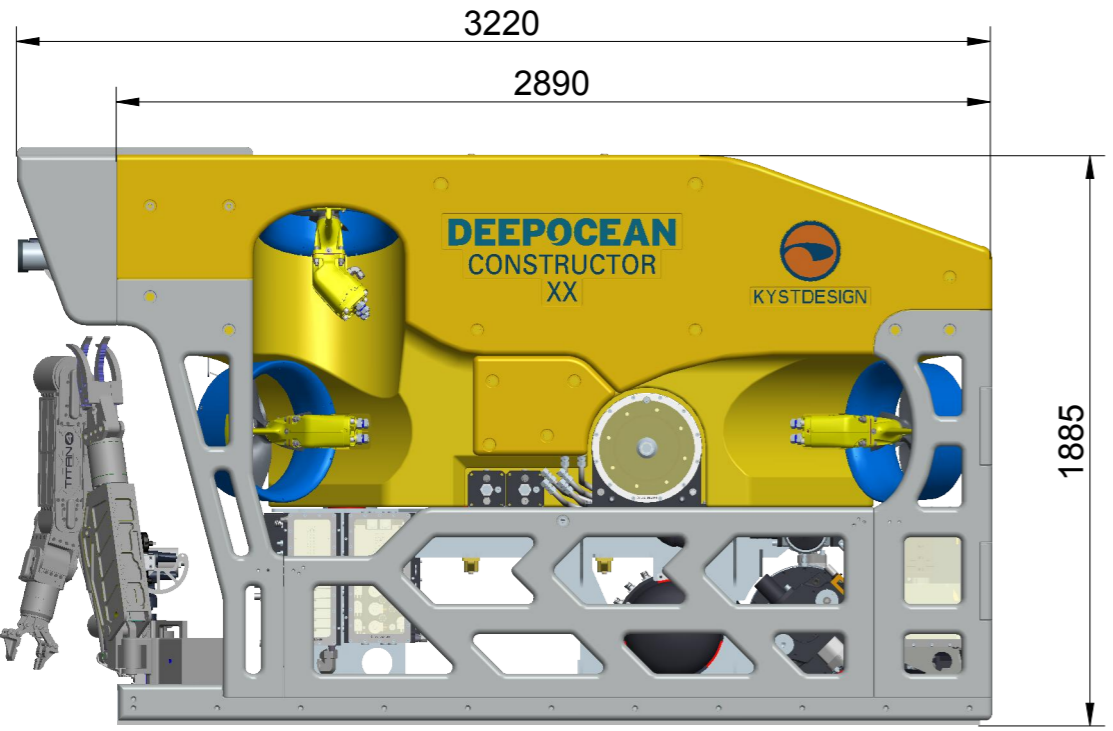


A

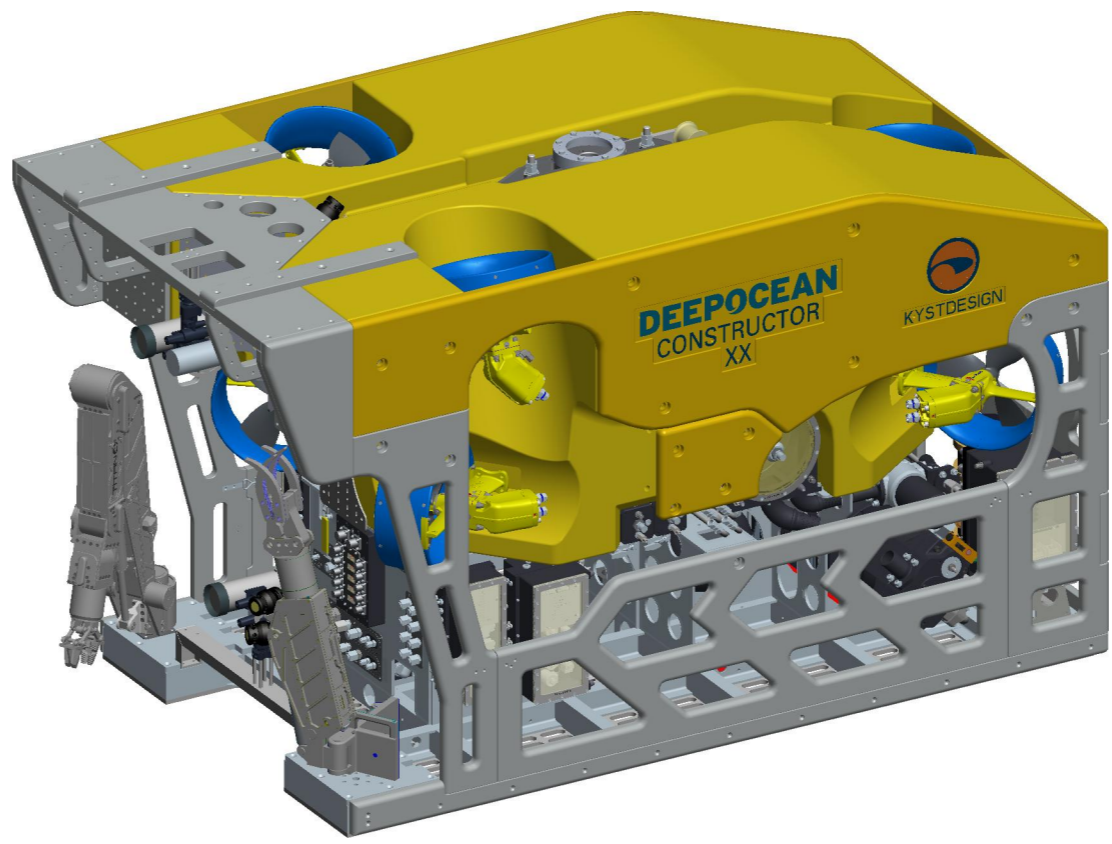

B

C

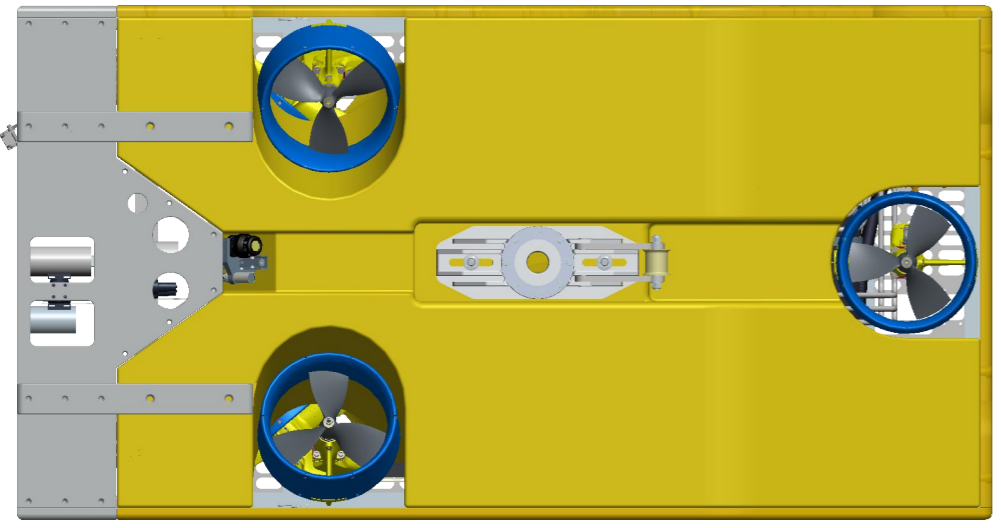

D

Weight in air:
ROV with Manipulators
and Pay load: 4440 kg
SWL lift point: 7000 kg
Through frame lift: 3000 kg
Pay load: ~600 kg
Depth Rating: 3000 msw

A

B

C

D

Itm.	Qty.	Description	Drg. / Spec.	Material	
01	26.04.13	AS BUILT	GVI	AHO EKB	
A	24.03.13	ISSUED FOR COMMENTS	GVI	AHO EKB	
Rev.	Date	Description	Prep	Chk	App

CONSTRUCTOR

Drawing title
CONSTRUCTOR
Without Skid
General Arrangement



Size
A3

KYSTDESIGN AS
Strandgaten 202, 5525 Haugesund, NORWAY
Tel: +47 52 70 62 50
Fax: +47 52 70 62 01
www.kystdesign.no

Scale
1:25
File name
AF25-1000M01

Sheet
2
of
4